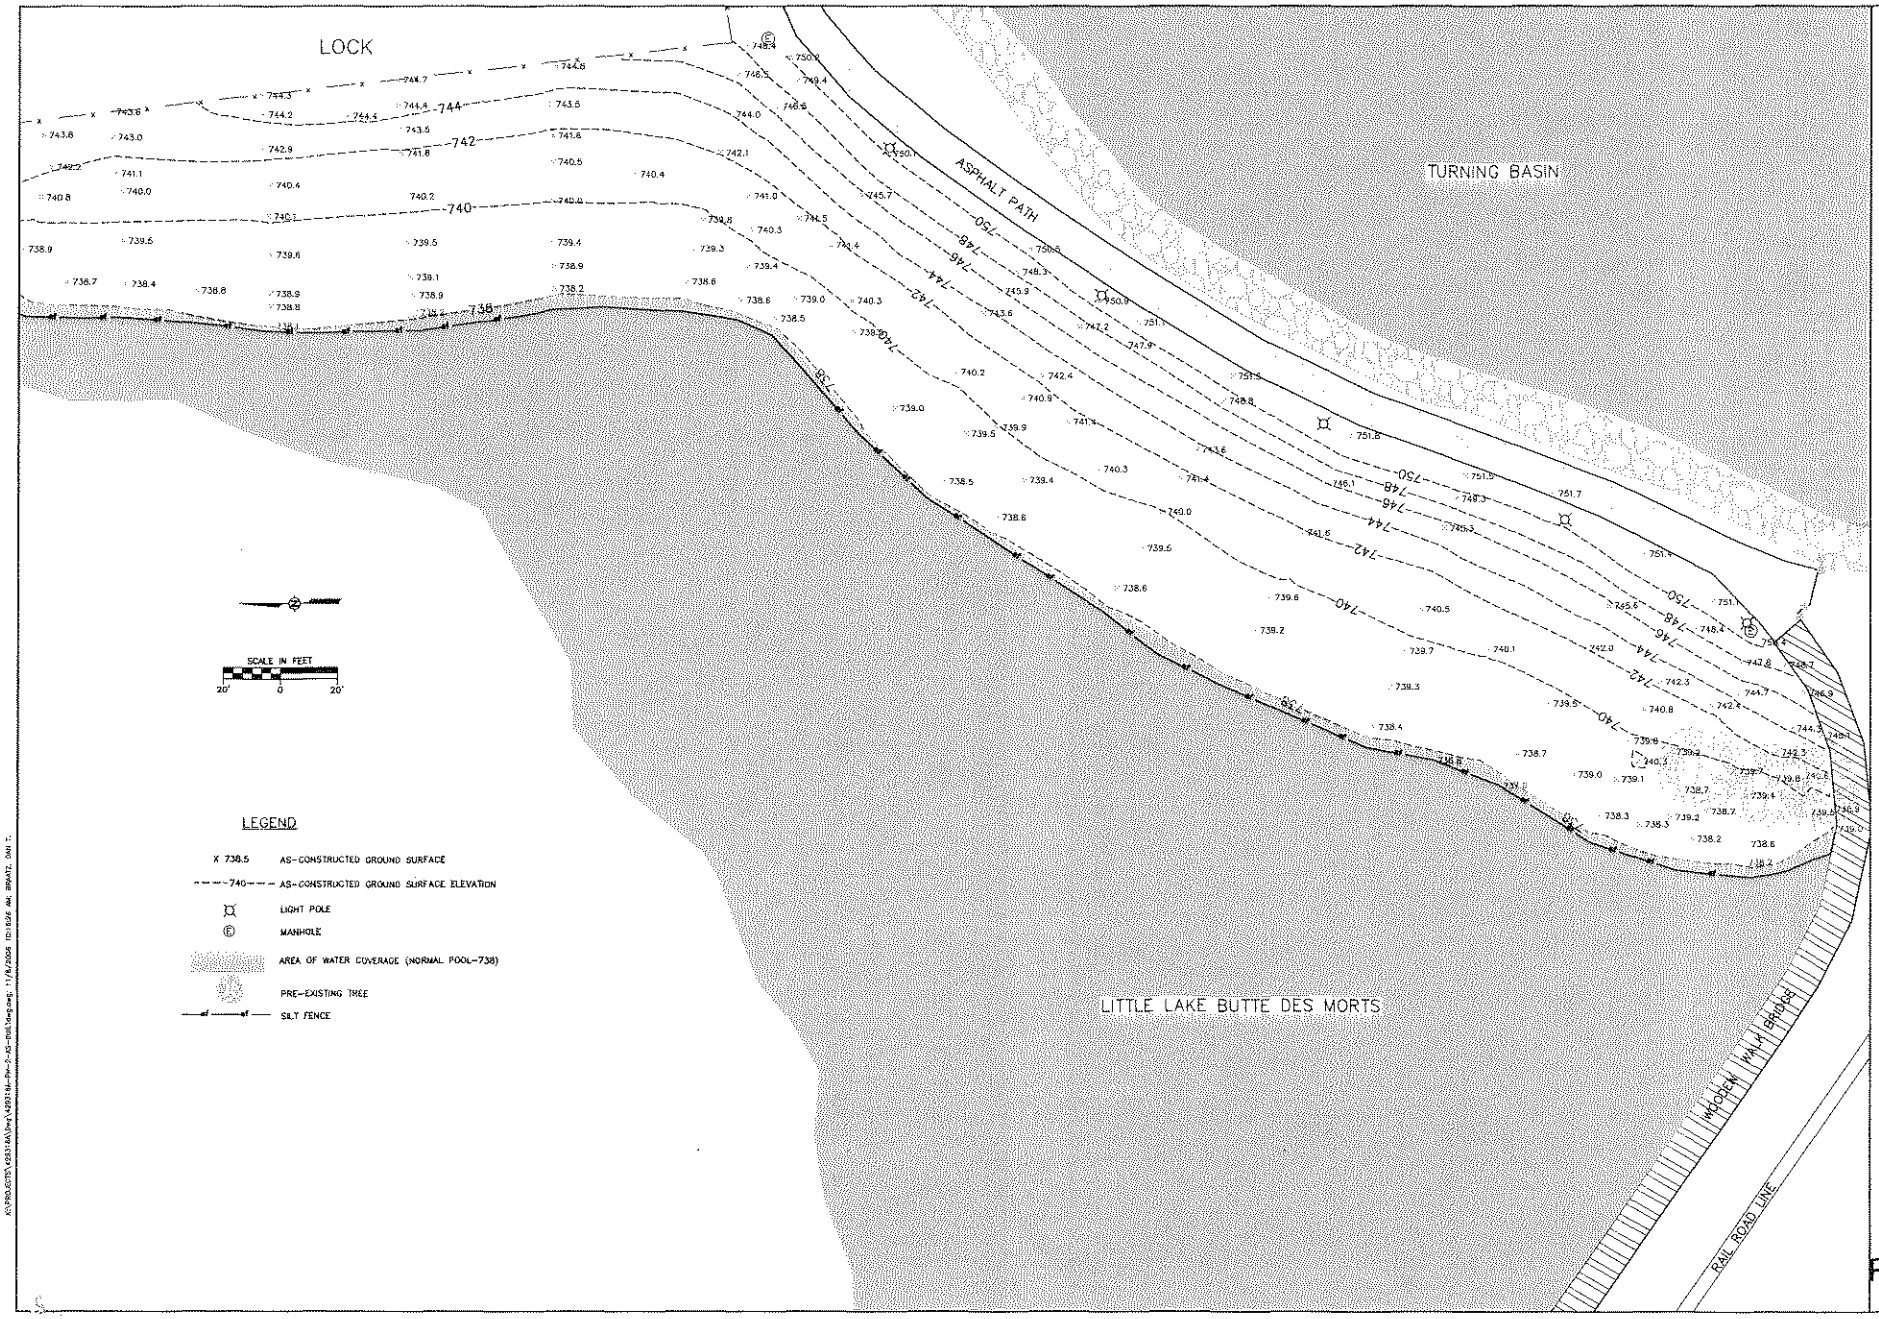

STS CONSULTANTS

1530 Hepler Drive
Green Bay, Wisconsin

920-468-1978

www.stsconsultants.com

Copyright 2006 ©
By: STS Consultants, Ltd.

PHASE 2 AS-CONSTRUCTED GRADES
POG1-B
GW PARTNERS LLC
MENASHA, WISCONSIN

Issued

Rev	Date	Description

Designed:
Drawn: DTB 10-25-06
Checked: SJS 10-06
Approved: SJS 10-06

PROJECT NUMBER
429316A

SHEET REFERENCE NUMBER
PH2-1-AC

SHEET 1 OF 2